
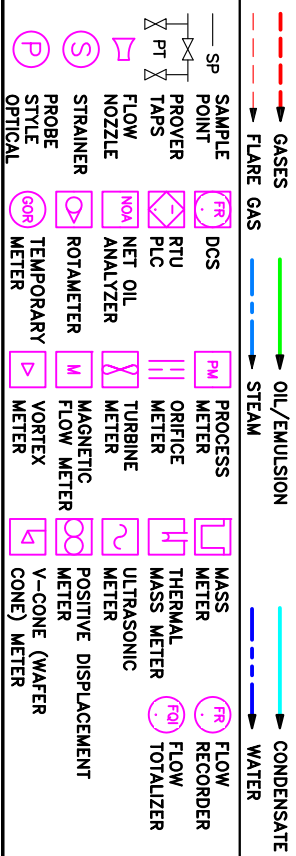


AB BT 0089133						WELL PAD A ORIGINAL					
WELL NAME	UWI	LSD	UC/OPER	DETAIL	STATUS	FUEL	TOE	HEEL			
A1S	105/05-32-064-04W4/00	09-32-064-04W4	HUSKY	OIL 2F	PRODUCING	-	FC-101A	FC-101N			
A2S	110/12-32-064-04W4/00	09-32-064-04W4	HUSKY	OIL 2F	PRODUCING	-	FC-102A	FC-102N			
A3S	108/12-32-064-04W4/00	09-32-064-04W4	HUSKY	OIL 2F	PRODUCING	-	FC-103A	FC-103N			
A4S	109/12-32-064-04W4/00	09-32-064-04W4	HUSKY	OIL 2F	PRODUCING	-	FC-104A	FC-104N			
A5S	107/12-32-064-04W4/00	09-32-064-04W4	HUSKY	OIL 2F	PRODUCING	-	FC-105A	FC-105N			
A6S	103/13-32-064-04W4/00	16-32-064-04W4	HUSKY	OIL 2F	PRODUCING	-	FC-106A	FC-106N			
A7S	107/13-32-064-04W4/00	16-32-064-04W4	HUSKY	OIL 2F	PRODUCING	-	FC-107A	FC-107N			
A8S	108/13-32-064-04W4/00	16-32-064-04W4	HUSKY	OIL 2F	PRODUCING	-	FC-108A	FC-108N			

AB BT 0089133						WELL PAD B					
WELL NAME	UWI	LSD	UC/OPER	DETAIL	STATUS	FUEL	TOE	HEEL			
B3P	103/04-32-064-04W4/00	01-32-064-04W4	HUSKY	OIL 2F	PRODUCING	-	FC-203A	FC-203N			
B4P	104/04-32-064-04W4/00	01-32-064-04W4	HUSKY	OIL 2F	PRODUCING	-	FC-204A	FC-204N			
B2P	106/04-32-064-04W4/00	01-32-064-04W4	HUSKY	OIL 2F	PRODUCING	-	FC-202A	FC-202N			
B1P	110/04-32-064-04W4/00	01-32-064-04W4	HUSKY	OIL 2F	PRODUCING	-	FC-201A	FC-201N			
BBP	103/05-32-064-04W4/00	08-32-064-04W4	HUSKY	OIL 2F	PRODUCING	-	FC-208A	FC-208N			
B7P	104/05-32-064-04W4/00	08-32-064-04W4	HUSKY	OIL 2F	PRODUCING	-	FC-207A	FC-207N			
B8P	106/05-32-064-04W4/00	01-32-064-04W4	HUSKY	OIL 2F	PRODUCING	-	FC-205A	FC-205N			
BBP	107/05-32-064-04W4/00	01-32-064-04W4	HUSKY	OIL 2F	PRODUCING	-	FC-206A	FC-206N			
B9P	104/15-32-064-04W4/00	08-32-064-04W4	HUSKY	OIL 2F	PRODUCING	-	FC-209A	FC-209N			
B10S	106/16-32-064-04W4/00	08-32-064-04W4	HUSKY	OIL 2F	PRODUCING	-	FC-210A	FC-210N			
B11S	107/16-32-064-04W4/00	08-32-064-04W4	HUSKY	OIL 2F	PRODUCING	-	FC-211A	FC-211N			
B12S	109/16-32-064-04W4/00	08-32-064-04W4	HUSKY	OIL 2F	PRODUCING	-	FC-212A	FC-212N			

AB BT 0089133						WELL PAD C					
WELL NAME	UWI	LSD	UC/OPER	DETAIL	STATUS	FUEL	TOE	HEEL			
C4P	107/11-29-064-04W4/00	09-29-064-04W4	HUSKY	OIL 2F	PRODUCING	-	FC-304A	FC-304N			
C1P	102/12-29-064-04W4/00	09-29-064-04W4	HUSKY	OIL 2F	PRODUCING	-	FC-301A	FC-301N			
C2P	103/12-29-064-04W4/00	09-29-064-04W4	HUSKY	OIL 2F	PRODUCING	-	FC-302A	FC-302N			
C3P	105/12-29-064-04W4/00	09-29-064-04W4	HUSKY	OIL 2F	PRODUCING	-	FC-303A	FC-303N			
C8P	102/13-29-064-04W4/00	09-29-064-04W4	HUSKY	OIL 2F	PRODUCING	-	FC-305A	FC-305N			
C8P	103/13-29-064-04W4/00	09-29-064-04W4	HUSKY	OIL 2F	PRODUCING	-	FC-306A	FC-306N			
C7P	104/13-29-064-04W4/00	16-29-064-04W4	HUSKY	OIL 2F	PRODUCING	-	FC-307A	FC-307N			
C8P	105/13-29-064-04W4/00	16-29-064-04W4	HUSKY	OIL 2F	PRODUCING	-	FC-308A	FC-308N			
C9P	105/07-32-064-04W4/00	16-29-064-04W4	HUSKY	OIL 2F	PRODUCING	-	FC-309A	FC-309N			

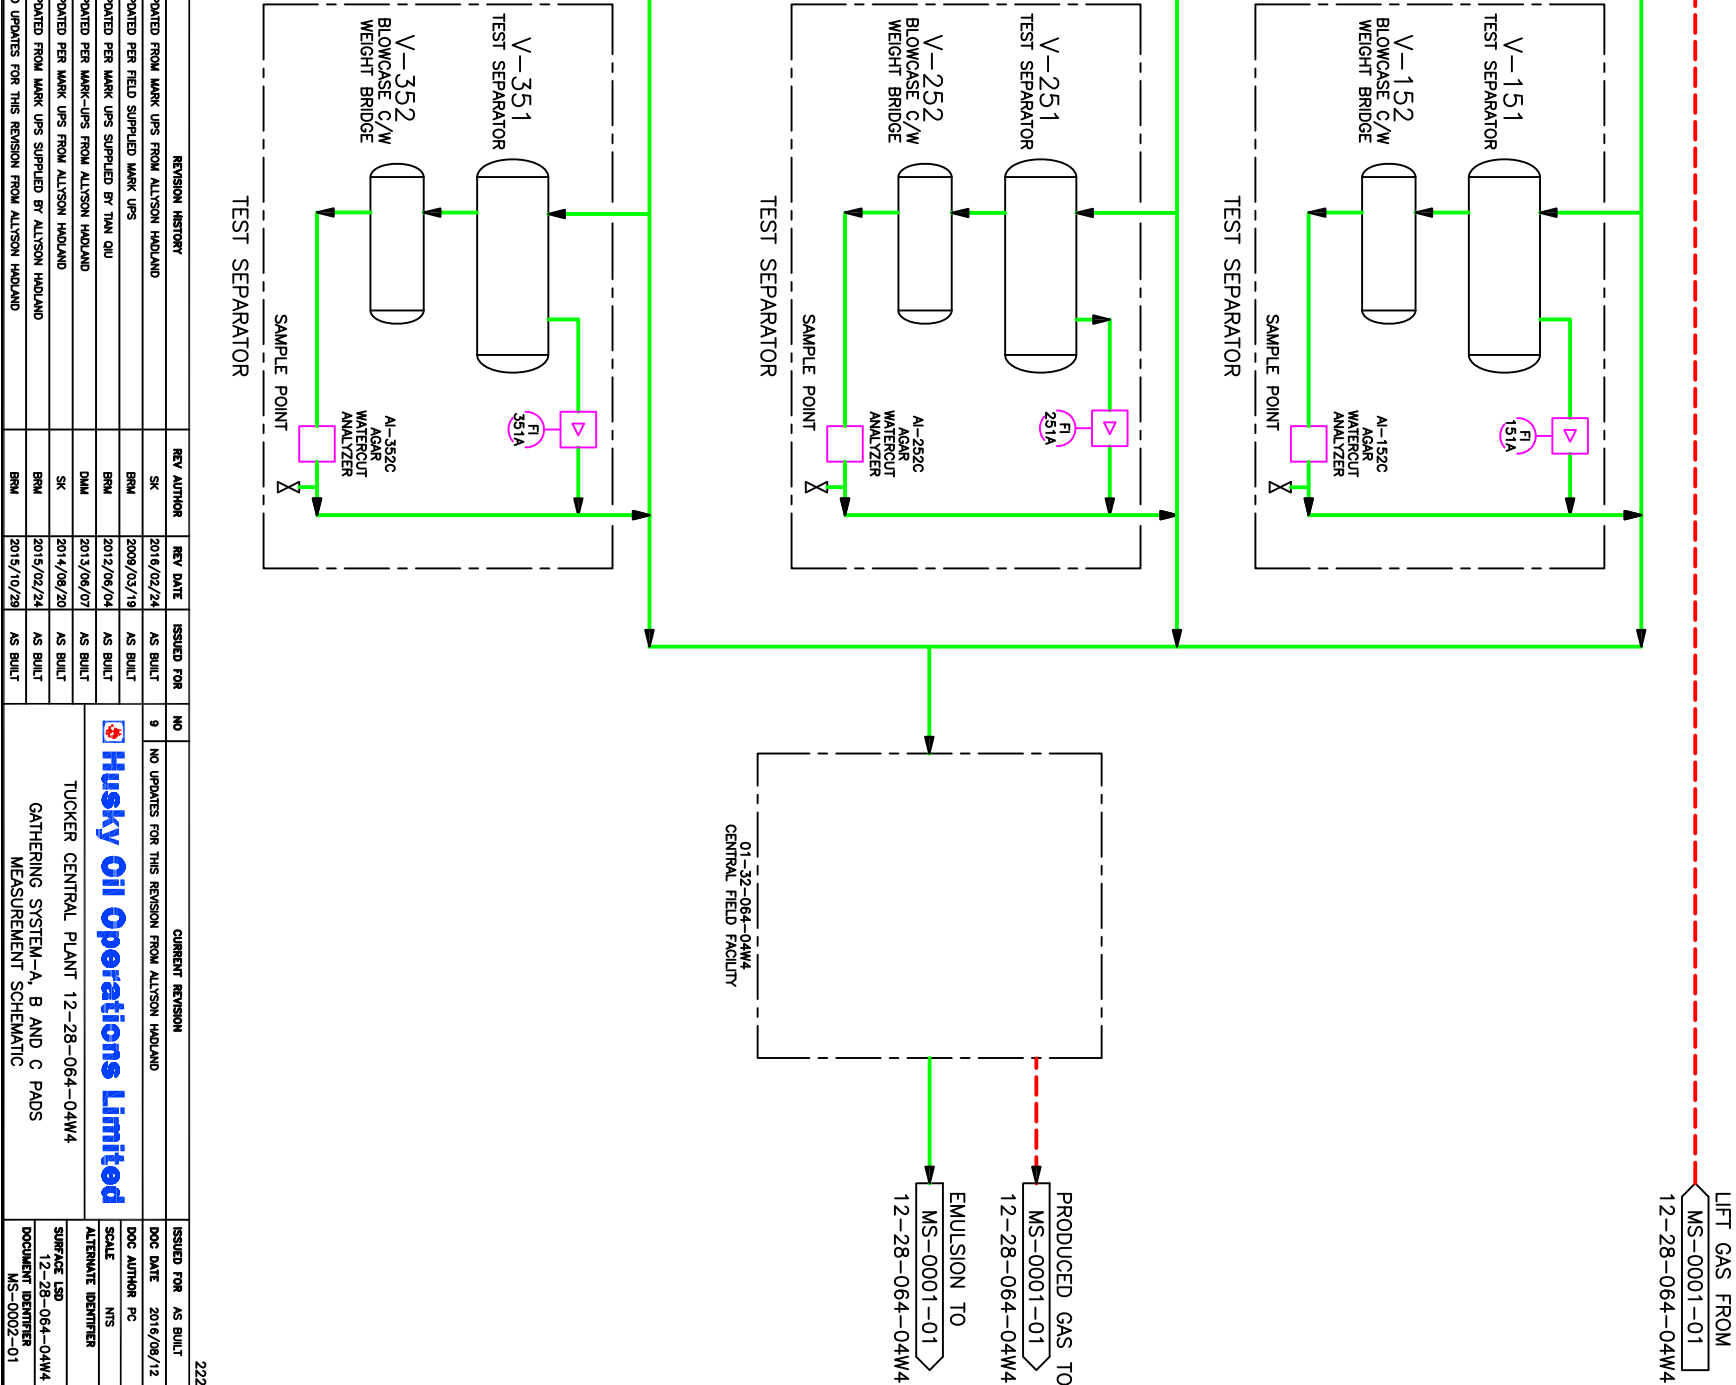

REFERENCE DRAWING DESCRIPTION				REVISION HISTORY				CURRENT REVISION			
REF. DWG. NO.	AREA OVERVIEW	NO.	DESCRIPTION	REV. AUTHOR	REV. DATE	ISSUED FOR	NO.	NO UPDATES FOR THIS REVISION FROM ALTYSON HADLAND	ISSUED FOR	AS BUILT	22206
MS-0000-01	FACILITY DRAWING	8	UPDATED FROM MARK UPS FROM ALTYSON HADLAND	SK	2016/02/24	AS BUILT	9	NO UPDATES FOR THIS REVISION FROM ALTYSON HADLAND	DOC DATE	2016/08/12	
MS-0001-01 & 02	GATHERING SYSTEM	2	UPDATED PER FIELD SUPPLIED MARK UPS	BM	2009/03/19	AS BUILT			DOC AUTHOR	NTS	
MS-0002-02 TO 05	STEAM INJECTION SYSTEM	3	UPDATED PER MARK UPS SUPPLIED BY TUN OUI	BM	2013/06/04	AS BUILT			SCALE	ALTERNATE IDENTIFIER	
MS-0007-01		4	UPDATED PER MARK-UPS FROM ALTYSON HADLAND	DMM	2013/06/07	AS BUILT					
MS-0010-01		5	UPDATED PER MARK UPS FROM ALTYSON HADLAND	SK	2014/08/20	AS BUILT					
		6	UPDATED FROM MARK UPS SUPPLIED BY ALTYSON HADLAND	BM	2015/02/24	AS BUILT					
		7	NO UPDATES FOR THIS REVISION FROM ALTYSON HADLAND	BM	2015/10/29	AS BUILT					
TUCKER CENTRAL PLANT 12-28-064-04W4											
GATHERING SYSTEM-A, B AND C PADS											
MEASUREMENT SCHEMATIC											
SURFACE ISO 12-28-064-04W4											
DOCUMENT MS-0002-01											