

AB BT 0089133						
WELL NAME		UWI	LSD	LC/OPER	DETAIL	STATUS
B9EP		111/16-32-064-04W4/00	01-32-064-04W4	HUSKY	OIL 2F	PRODUCING
						FUEL
						TOE
						HEEL


LIFT GAS FROM
MS-0001-01
12-28-064-04W4

AB BT 0089133						
WELL NAME		UWI	LSD	LC/OPER	DETAIL	STATUS
B10EP		113/16-32-064-04W4/00	01-32-064-04W4	HUSKY	OIL 2F	PRODUCING
						FUEL
						TOE
						HEEL

PRODUCED GAS TO
MS-0001-01
12-28-064-04W4

EMULSION TO
MS-0001-01
12-28-064-04W4

AB BT 0089133						
WELL NAME		UWI	LSD	LC/OPER	DETAIL	STATUS
B11EP		115/16-32-064-04W4/00	01-32-064-04W4	HUSKY	OIL 2F	PRODUCING
						FUEL
						TOE
						HEEL

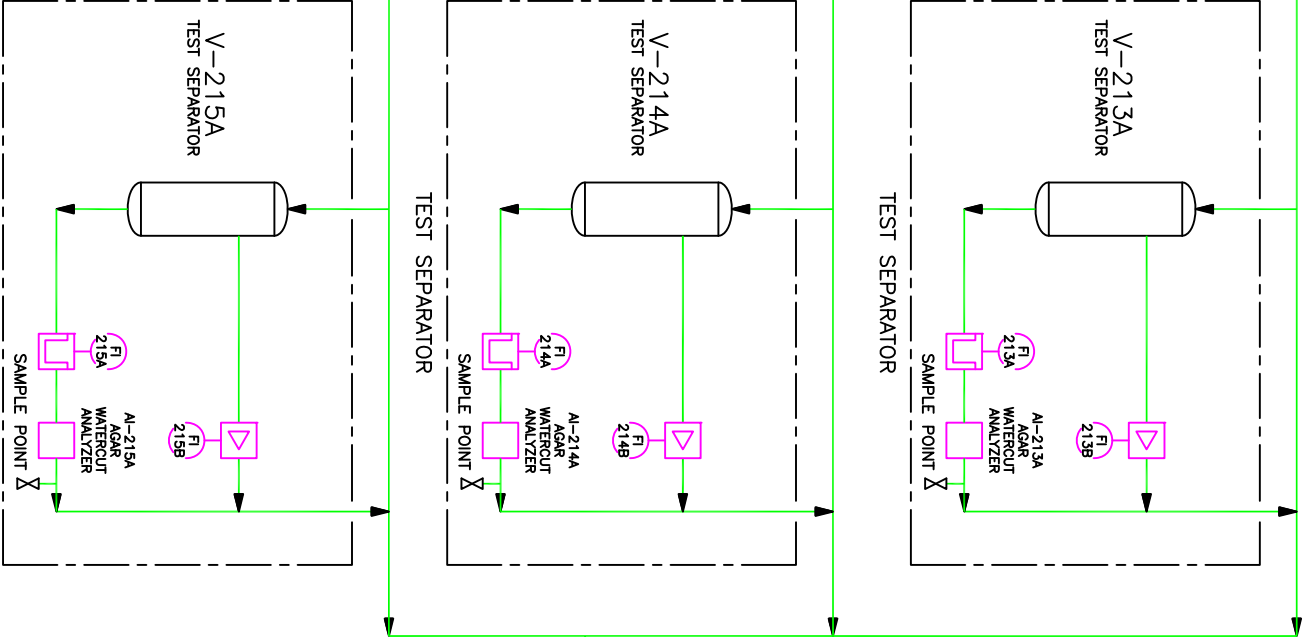

SP

POINT

PROVER

TAPS

NOZZLE

FLOW

STRAINER

PROBE

STYLE

OPTICAL

FR

DCS

RTU

PLC

NET OIL

ANALYZER

ROTAMETER

TEMPORARY

METER

PM

PROCESS

METER

ORIFICE

METER

TURBINE

METER

MAGNETIC

FLOW METER

V-CONE (WAFER

CONE) METER

FR

FLOW

REORDER

FLOW

REORDER

FLOW

REORDER

FLOW

REORDER

MS-0001-01

MS-0001-01 & 02

MS-0002-01/02/04/05

MS-0007-01

MS-0010-01

AREA OVERVIEW

FACILITY DRAWING

GATHERING SYSTEM

STEAM INJECTION SYSTEM

LOCUT UNIT

NO

1

2

3

4

5

6

7

REVISION HISTORY

UPDATED PER MARK UPS SUPPLIED BY TUN OIL

UPDATED PER MARK-UPS FROM ALLISON HADLAND

UPDATED PER MARK UPS FROM ALLISON HADLAND

UPDATED FROM MARK UPS SUPPLIED BY ALLISON HADLAND

NO UPDATES FOR THIS REVISION FROM ALLISON HADLAND

UPDATED FROM MARK UPS FROM ALLISON HADLAND

REV AUTHOR

WDA

DMM

SK

BRM

BRM

BRM

REV DATE

2012/02/01

2013/06/07

2014/06/20

2015/02/24

2015/10/29

2016/02/24

ISSUED FOR

AS BUILT

AS BUILT

NO

7

CURRENT REVISION

NO UPDATES FOR THIS REVISION FROM ALLISON HADLAND

ISSUED FOR

AS BUILT

DOC DATE

2016/08/12

DOC AUTHOR

PC

SCALE

NTS

ALTERNATE IDENTIFIER

SHEET NO

12-28-064-04W4

DOCUMENT NUMBER

MS-0002-03