


AB BT 0089133					WELL PAD C EAST				
WELL NAME	UWI	LSD	LC/OPER	DETAIL	STATUS	FUEL	TOE	HEEL	
C20P	104/07-28-064-04W4/00	09-29-064-04W4	HUSKY	OIL 2F	PRODUCING	-	FC-320A	N/A	
C18P	100/10-28-064-04W4/00	09-29-064-04W4	HUSKY	OIL 2F	PRODUCING	-	FC-316A	N/A	
C18P	102/10-28-064-04W4/00	09-29-064-04W4	HUSKY	OIL 2F	PRODUCING	-	FC-318A	N/A	
C17P	104/10-28-064-04W4/00	09-29-064-04W4	HUSKY	OIL 2F	PRODUCING	-	FC-317A	N/A	
C19P	106/10-28-064-04W4/00	09-29-064-04W4	HUSKY	OIL 2F	PRODUCING	-	FC-319A	N/A	
C14P	103/15-28-064-04W4/00	16-29-064-04W4	HUSKY	OIL 2F	PRODUCING	-	FC-314A	N/A	
C13P	105/15-28-064-04W4/00	16-29-064-04W4	HUSKY	OIL 2F	PRODUCING	-	FC-313A	N/A	
C15P	107/15-28-064-04W4/00	16-29-064-04W4	HUSKY	OIL 2F	PRODUCING	-	FC-315A	N/A	

AB BT 0089133					WELL PAD A SOUTH				
WELL NAME	UWI	LSD	LC/OPER	DETAIL	STATUS	FUEL	TOE	HEEL	
A20P	113/12-32-064-04W4/00	09-32-064-04W4	HUSKY	OIL 2F	PRODUCING	-	FC-120N	FC-120P	
A18P	114/12-32-064-04W4/02	09-32-064-04W4	HUSKY	OIL 2F	PRODUCING	-	FC-118N	FC-118P	
A17P	116/12-32-064-04W4/00	09-32-064-04W4	HUSKY	OIL 2F	PRODUCING	-	FC-117N	FC-117P	
A19P	119/12-32-064-04W4/00	09-32-064-04W4	HUSKY	OIL 2F	PRODUCING	-	FC-119N	FC-119P	

AB BT 0089133					WELL PAD A NORTH				
WELL NAME	UWI	LSD	LC/OPER	DETAIL	STATUS	FUEL	TOE	HEEL	
A16P	124/12-32-064-04W4/00	09-32-064-04W4	HUSKY	OIL 2F	PRODUCING	-	FC-116N	FC-116P	
A15P	125/12-32-064-04W4/00	09-32-064-04W4	HUSKY	OIL 2F	PRODUCING	-	FC-115N	FC-115P	
A9P	109/13-32-064-04W4/00	16-32-064-04W4	HUSKY	OIL 2F	PRODUCING	-	FC-109N	FC-109P	
A12P	112/13-32-064-04W4/00	16-32-064-04W4	HUSKY	OIL 2F	PRODUCING	-	FC-112N	FC-112P	
A11P	113/13-32-064-04W4/00	16-32-064-04W4	HUSKY	OIL 2F	PRODUCING	-	FC-111N	FC-111P	
A10P	115/13-32-064-04W4/00	16-32-064-04W4	HUSKY	OIL 2F	PRODUCING	-	FC-110N	FC-110P	
A13P	117/13-32-064-04W4/00	09-32-064-04W4	HUSKY	OIL 2F	PRODUCING	-	FC-113N	FC-113P	
A14P	107/15-28-064-04W4/00	09-32-064-04W4	HUSKY	OIL 2F	PRODUCING	-	FC-114N	FC-114P	

AB BT 0089133					WELL PAD A SOUTH				
WELL NAME	UWI	LSD	LC/OPER	DETAIL	STATUS	FUEL	TOE	HEEL	
A23P	113/05-32-064-04W4/00	09-32-064-04W4	HUSKY	OIL 2F	PRODUCING	-	FC-123N	FC-123P	
A24P	114/05-32-064-04W4/00	09-32-064-04W4	HUSKY	OIL 2F	PRODUCING	-	FC-124N	FC-124P	
A22P	120/12-32-064-04W4/00	09-32-064-04W4	HUSKY	OIL 2F	PRODUCING	-	FC-122N	FC-122P	
A21P	122/12-32-064-04W4/00	09-32-064-04W4	HUSKY	OIL 2F	PRODUCING	-	FC-121N	FC-121P	

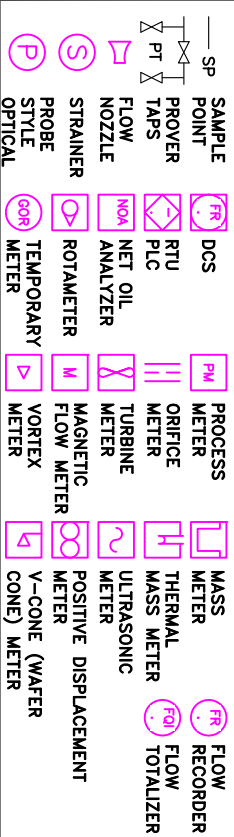

REF. DWG NO		AREA OVERVIEW		REFERENCE DRAWING DESCRIPTION		REVISION HISTORY		CURRENT REVISION		ISSUED FOR	
MS-0000-01		FACILITY DRAWING		MS-0001-01 & 02		1		NO UPDATES TO THIS REVISION FROM ALTYSON HIGHLAND		AS BUILT	
MS-0002-01.03.04.05		GATHERING SYSTEM		MS-0007-01		2		NO UPDATES TO THIS REVISION FROM ALTYSON HIGHLAND		AS BUILT	
MS-0010-01		STEAM INJECTION SYSTEM		LOCIT UNIT		3		NO UPDATES TO THIS REVISION FROM ALTYSON HIGHLAND		AS BUILT	
						4		NO UPDATES TO THIS REVISION FROM ALTYSON HIGHLAND		AS BUILT	
						5		NO UPDATES TO THIS REVISION FROM ALTYSON HIGHLAND		AS BUILT	
						6		NO UPDATES TO THIS REVISION FROM ALTYSON HIGHLAND		AS BUILT	
						7		NO UPDATES TO THIS REVISION FROM ALTYSON HIGHLAND		AS BUILT	

Husky Oil Operations Limited		TUCKER CENTRAL PLANT 12-28-064-04W4		GATHERING SYSTEM-A AND C PADS		MEASUREMENT SCHEMATIC	
22206		DOCS		DOC DATE		2016/08/12	
		SCALE		SCALE		IDENTIFIER	
		SURFACE LSD		SURFACE LSD		12-28-064-04W4	
		DOCUMENT		DOCUMENT		MS-0002-02	

